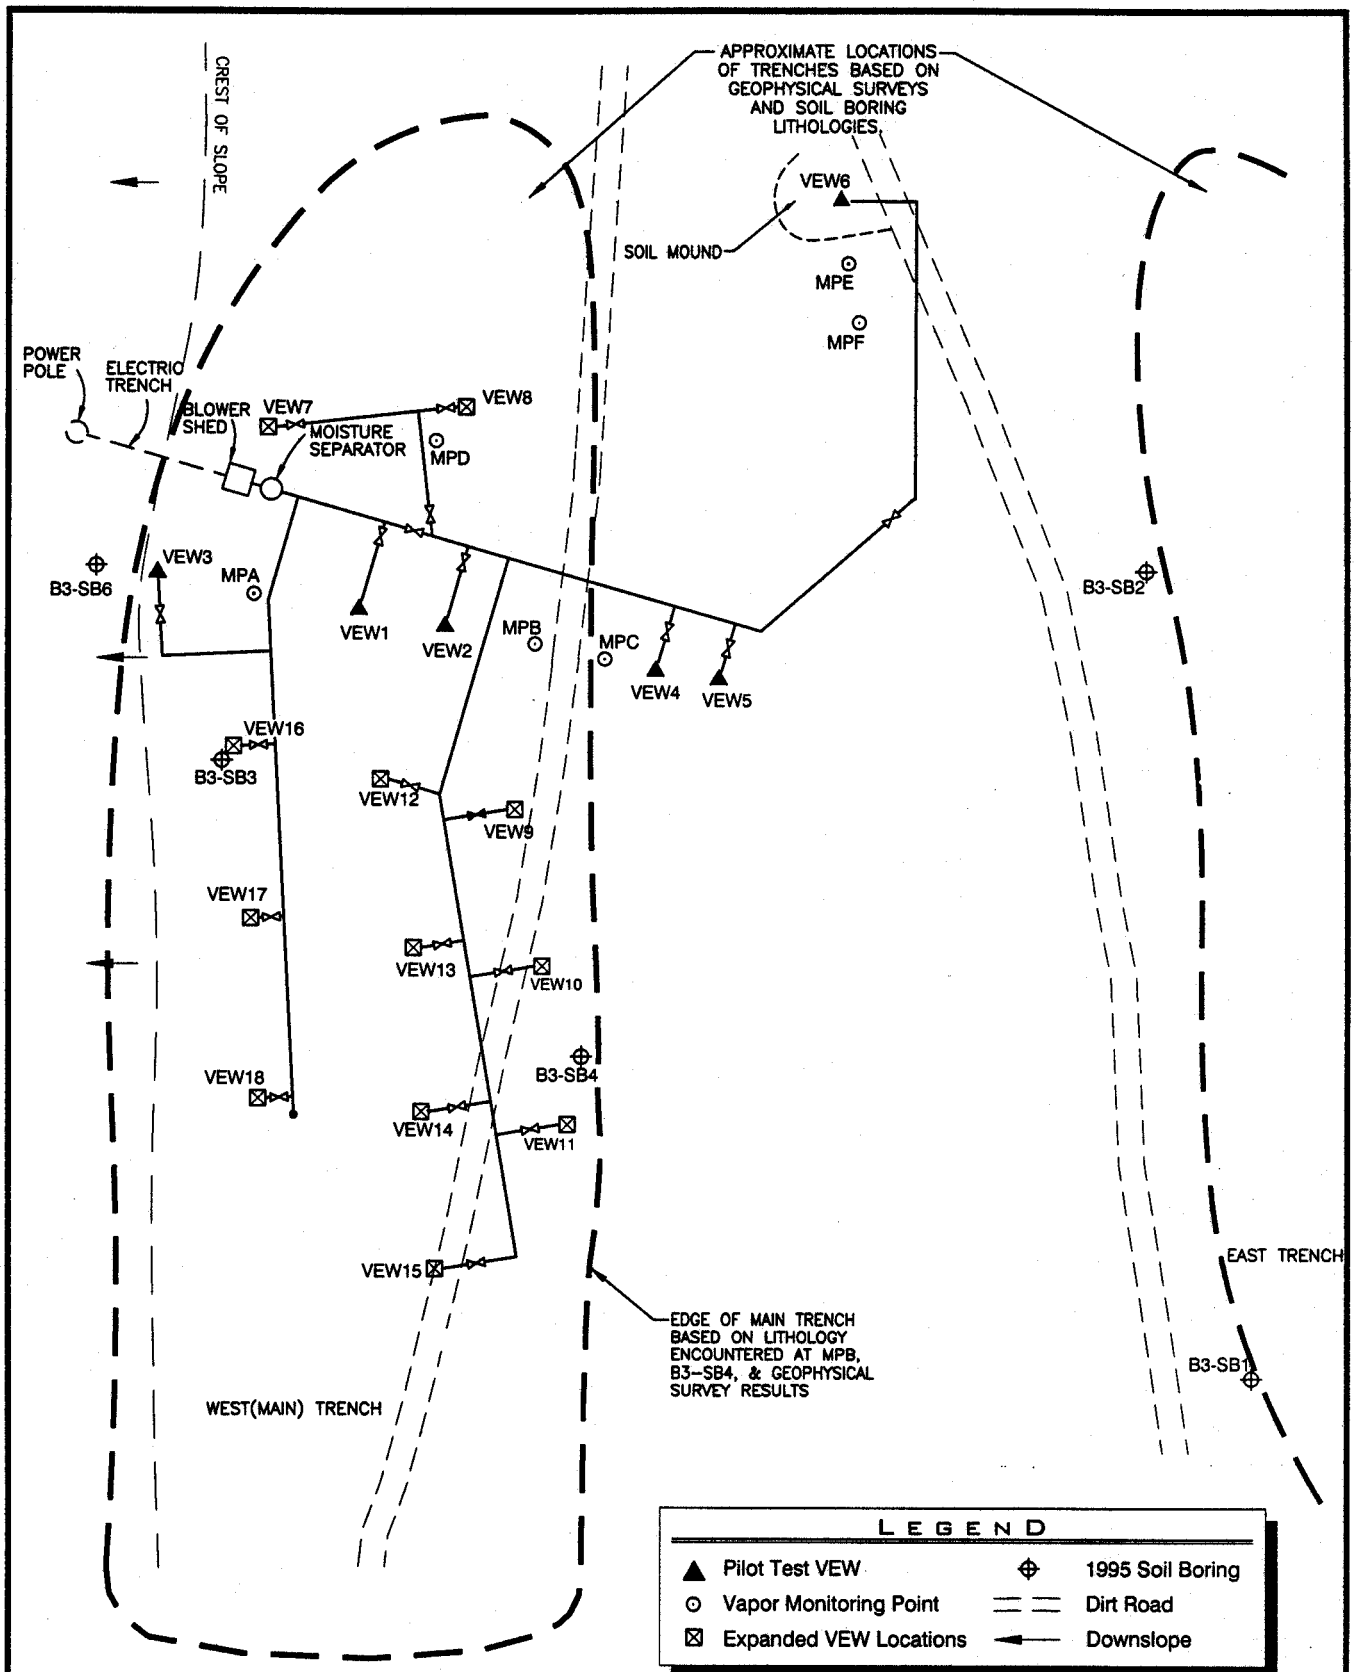

Figure 3.1

SWMU B-3
As-Built Expanded SVE System Layout

Camp Stanley Storage Activity - October 2001

PARSONS ENGINEERING SCIENCE, INC.

728487 CSSA-B3-SVE.DWG